

BROWN + RAWDON ARCHITECTS

MARCH, 1974

ADMINISTRATION BUILDING - COUNTY OF RIVERSIDE  
 CORONA CIVIC CENTER - BUENA VISTA AVE., CORONA, CALIFORNIA.



MIDDLE LEVEL FLOOR PLAN AS BUILT

313


CR 403 184



HAUGHTON ELEV

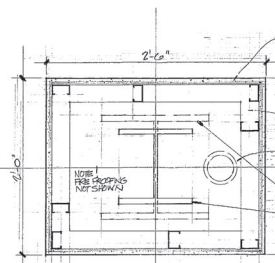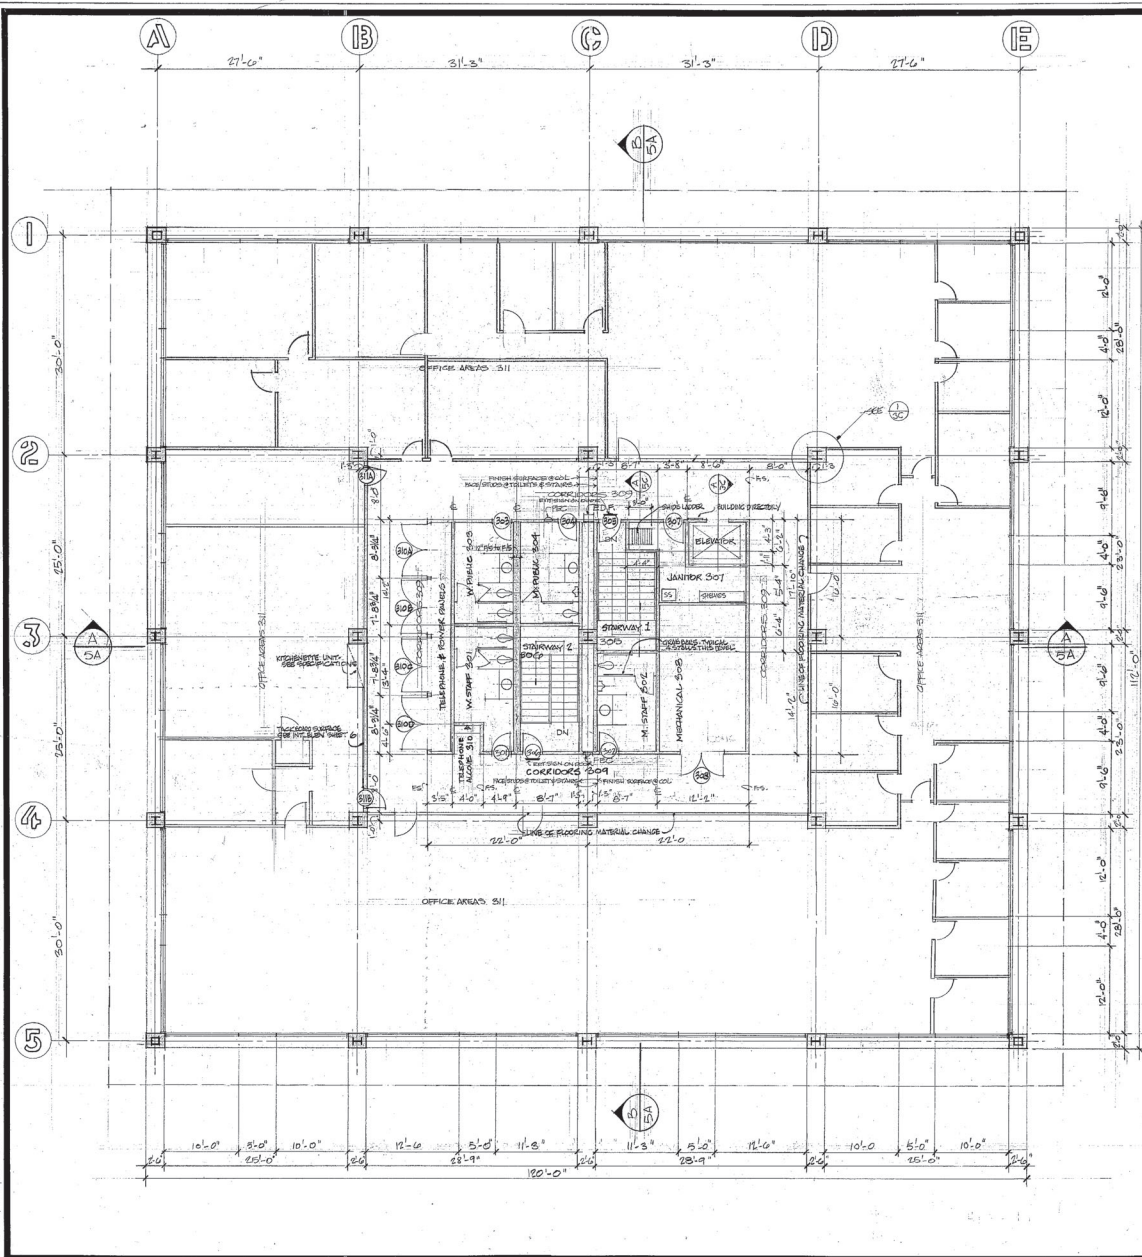

TYP. COLUMN FORMING  
1/8" = 1'-0"

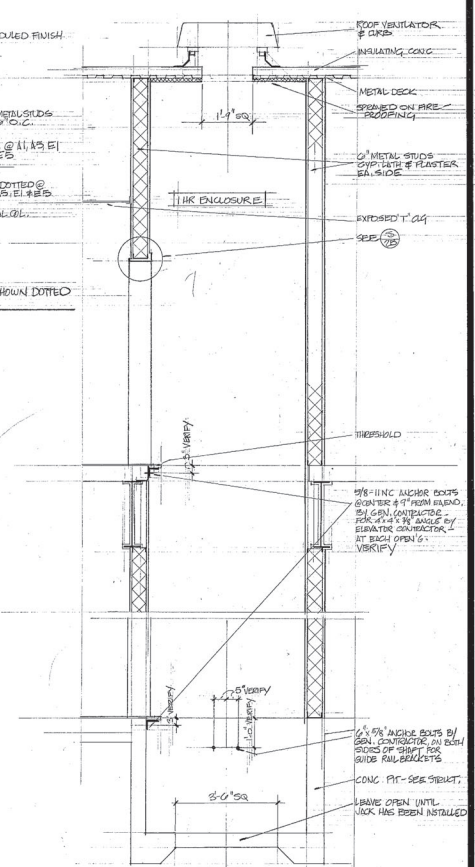

ELEVATOR SHAFT  
1/8" = 1'-0"



NOT FOR BIDDING PURPOSES SCALE 1/8" = 1'-0"

BROWN + RAWDON ARCHITECTS

MARCH, 1974

ADMINISTRATION BUILDING - COUNTY OF RIVERSIDE  
CORONA CIVIC CENTER - BUELLA VISTA AVENUE, CORONA, CALIFORNIA

UPPER LEVEL FLOOR PLAN  
ELEVATOR SHAFT

AS BUILT  
30